


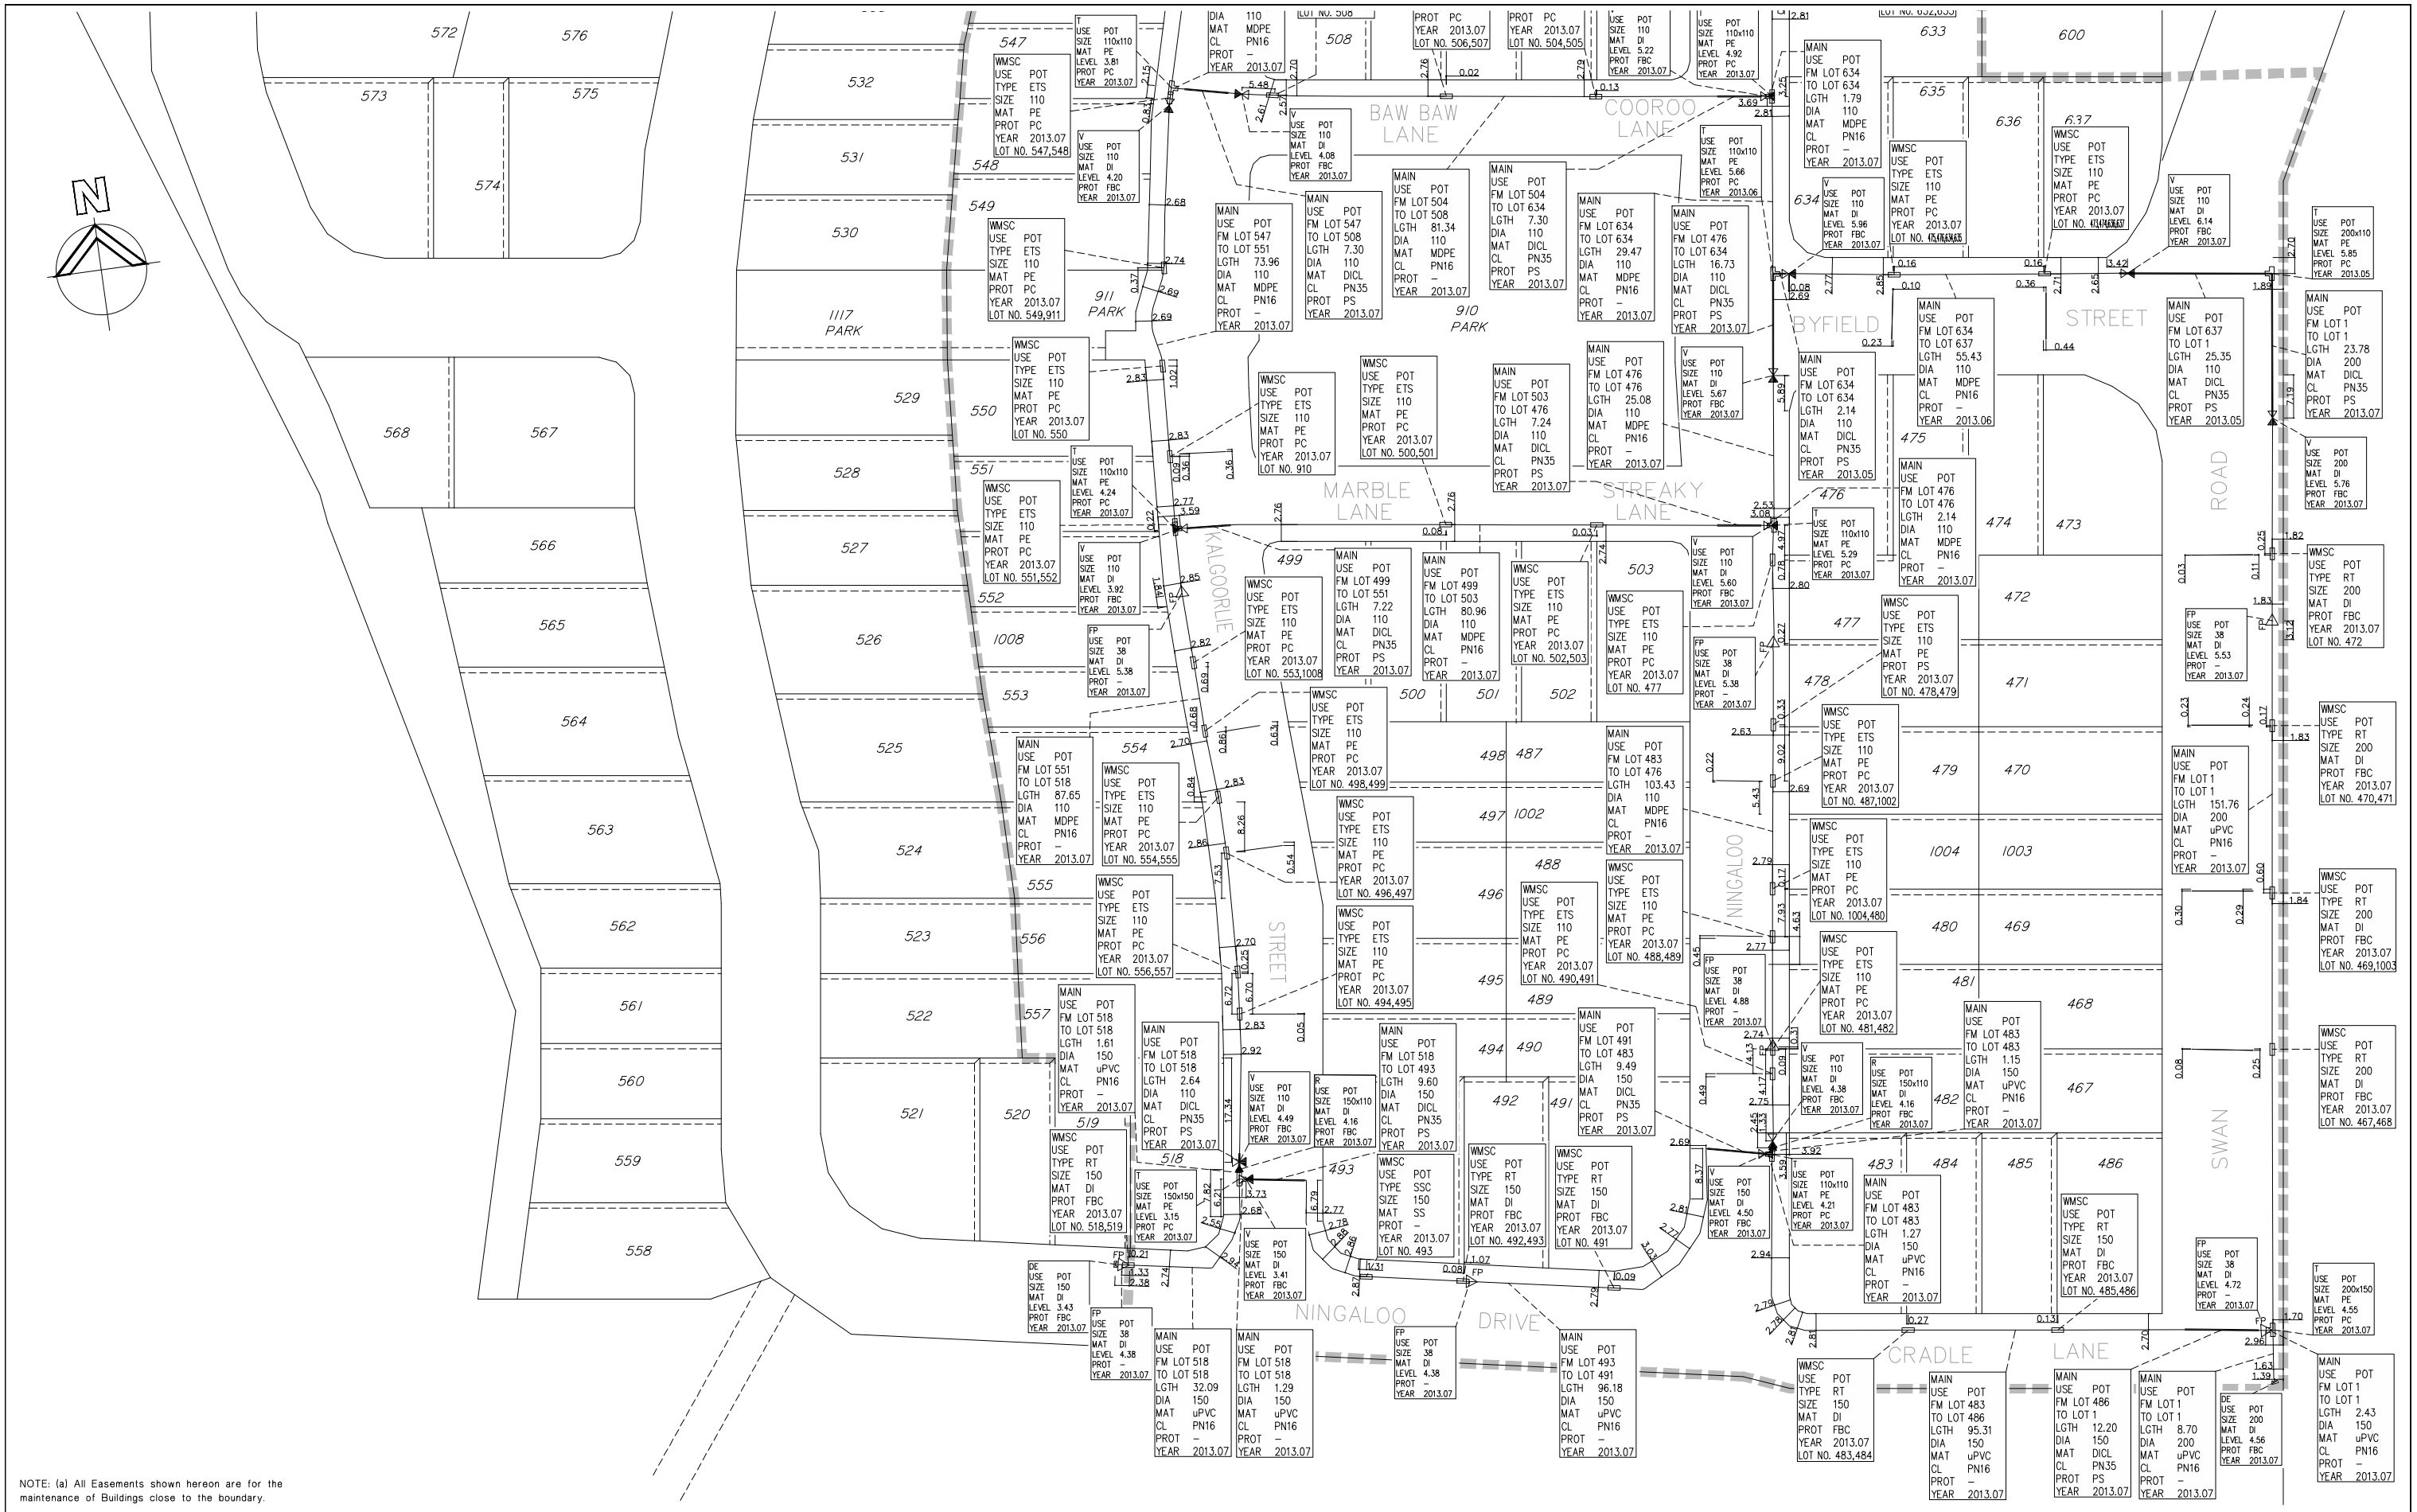

NOTE: (a) All Easements shown hereon are for the maintenance of Buildings close to the boundary.

ISSUE	DATE	AUTHOR	COMMENTS
A	12/11/2013	DPM	INITIAL DRAFT OF POTABLE WATER



LANDPARTNERS
built environment consultants

Brisbane Office
13 Railway Terrace
Milton QLD 4054
PO Box 3916
South Brisbane BC QLD 4101
t (07) 3842 1000
f (07) 3842 1001
e info@landpartners.com.au
www.landpartners.com.au



ISO 9001:2008
FS 53693

CLIENT

MIRVAC PACIFIC

PROJECT

PRECINCT 6.3
POTABLE WATER AS CONSTRUCTED
FINAL
LOTS 467-503 SP257545

APOGIATE CONSULTANT

KN GROUP PTY LTD

LOCAL GOVERNMENT

GOLD COAST CITY COUNCIL

SCALE

0 10 25 55m

SCALE 1:500 (A1)

DATUM	AHDD
LEVEL ORIGIN	PSM 166836 RL 6.838
CONTOUR INTERVAL	N/A
COMPUTER FILE	459563D3
DRAWN	DPM
CHECKED	DATE 12/11/2013
APPROVED	DATE
PLAN NUMBER	SHEET 1 OF 2
BRJD4595-063-088	REV A



NOTE: (a) All Easements shown hereon are for the maintenance of Buildings close to the boundary.

ISSUE	DATE	AUTHOR	COMMENTS
A	12/11/2013	DPM	INITIAL DRAFT OF POTABLE WATER



Brisbane Office
13 Railway Terrace
Milton QLD 4054
PO Box 3916
South Brisbane BC QLD 4101
(07) 3842 1000
f 07) 3842 1001
e info@landpartners.com.au
www.landpartners.com.au
ISO 9001:2008
F8 536903

CLIENT
MIRVAC PACIFIC

PROJECT
**PRECINCT 6.3
POTABLE WATER AS CONSTRUCTED
FINAL
LOTS 467-503 SP257545**

APOGIATE CONSULTANT
KN GROUP PTY LTD

LOCAL GOVERNMENT
GOLD COAST CITY COUNCIL

SCALE
0 10 25 55m
SCALE 1:500 (A1)

DATUM AHDD
LEVEL ORIGIN PSM 166836 RL 6.838
CONTOUR INTERVAL N/A
COMPUTER FILE 459563D3
DRAWN DPM DATE 12/11/2013
CHECKED DATE
APPROVED DATE
PLAN NUMBER BRJD4595-063-088 SHEET 2 OF 2 REV A