



ISSUE	DATE	AUTHOR	COMMENTS
A	11/11/2011	ASW	PRELIMINARY IPUE
B	03/01/2012	PJH	DETAIL UPDATE
C	13/01/2012	PJH	DETAIL UPDATE
D	18/01/2012	PJH	DETAIL UPDATE
E	11/04/2012	PJH	DETAIL UPDATE
F	25/06/2012	PJH	DETAIL UPDATE
G	27/06/2012	CMA	COVER TYPES AMENDED

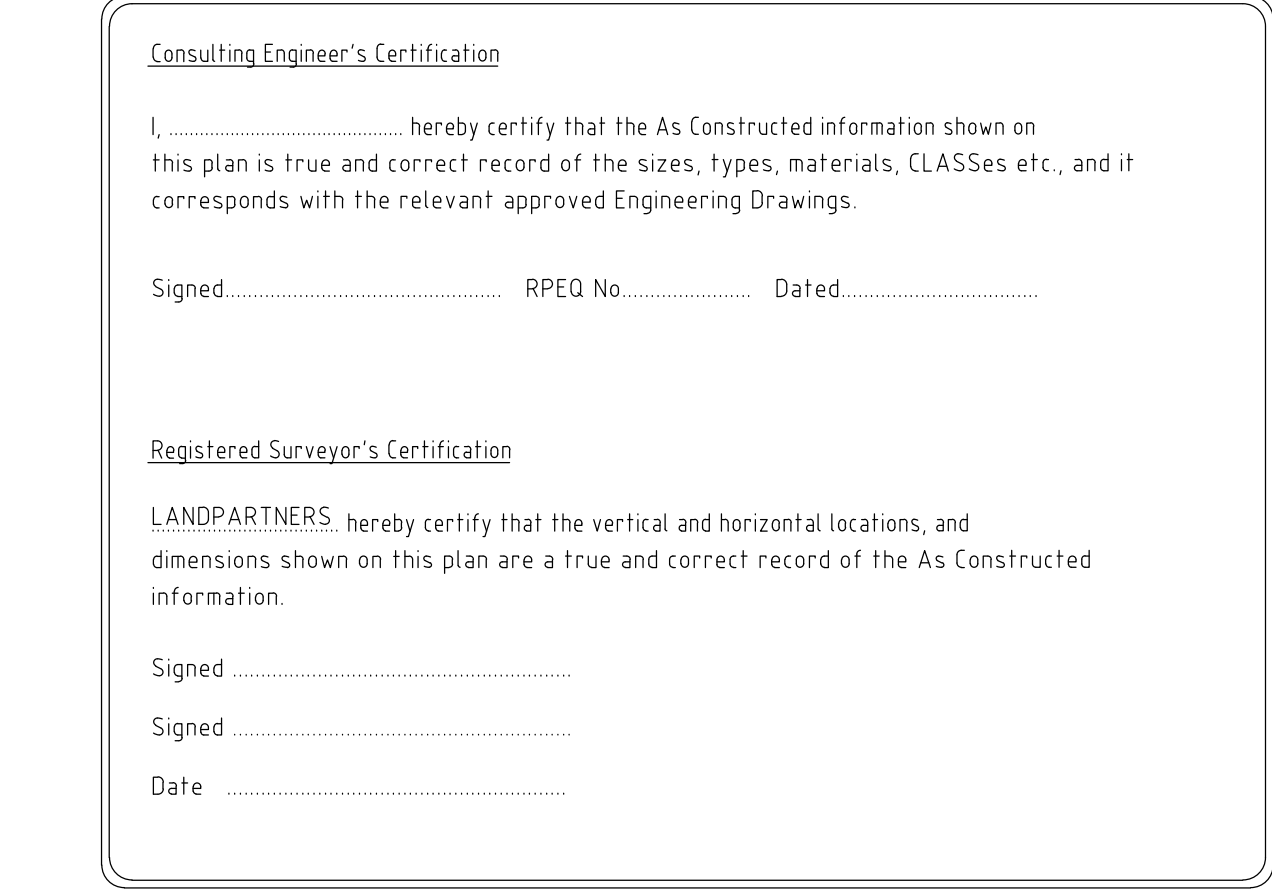

Brisbane Office
13 Railway Terrace
Milton QLD 4064
PO Box 3916
South Brisbane BC QLD 410
t (07) 3842 1000
f (07) 3842 1001
e info@landpartners.com.au
w www.landpartners.com.au

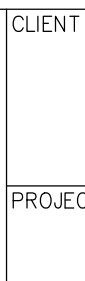

CLIENT	MIRVAC PACIFIC
PROJECT	PRECINCT 6.1 SEWER AS CONSTRUCTED FINAL LOTS 333-345, 350-376 & 392-398 SP242343

CLIENT
PROJECT

APOCIATE CONSULTANT

KN GROUP PTY LTD

LOCAL GOVERNMENT

GOLD COAST CITY COUNCIL

SCALE

0	10	25	55
---	----	----	----

DATUM	AWDD
-------	------

LEVEL ORIGIN	PSM 166836 RL 6.838
--------------	---------------------

CONTOUR INTERVAL	N/A
------------------	-----

COMPUTER FILE	45950
---------------	-------


DRAWN	CMA
-------	-----

CHECKED ADR

APPROVED

PLAN NUMBER	BRJD4595-006-044
-------------	------------------

IPUE
G

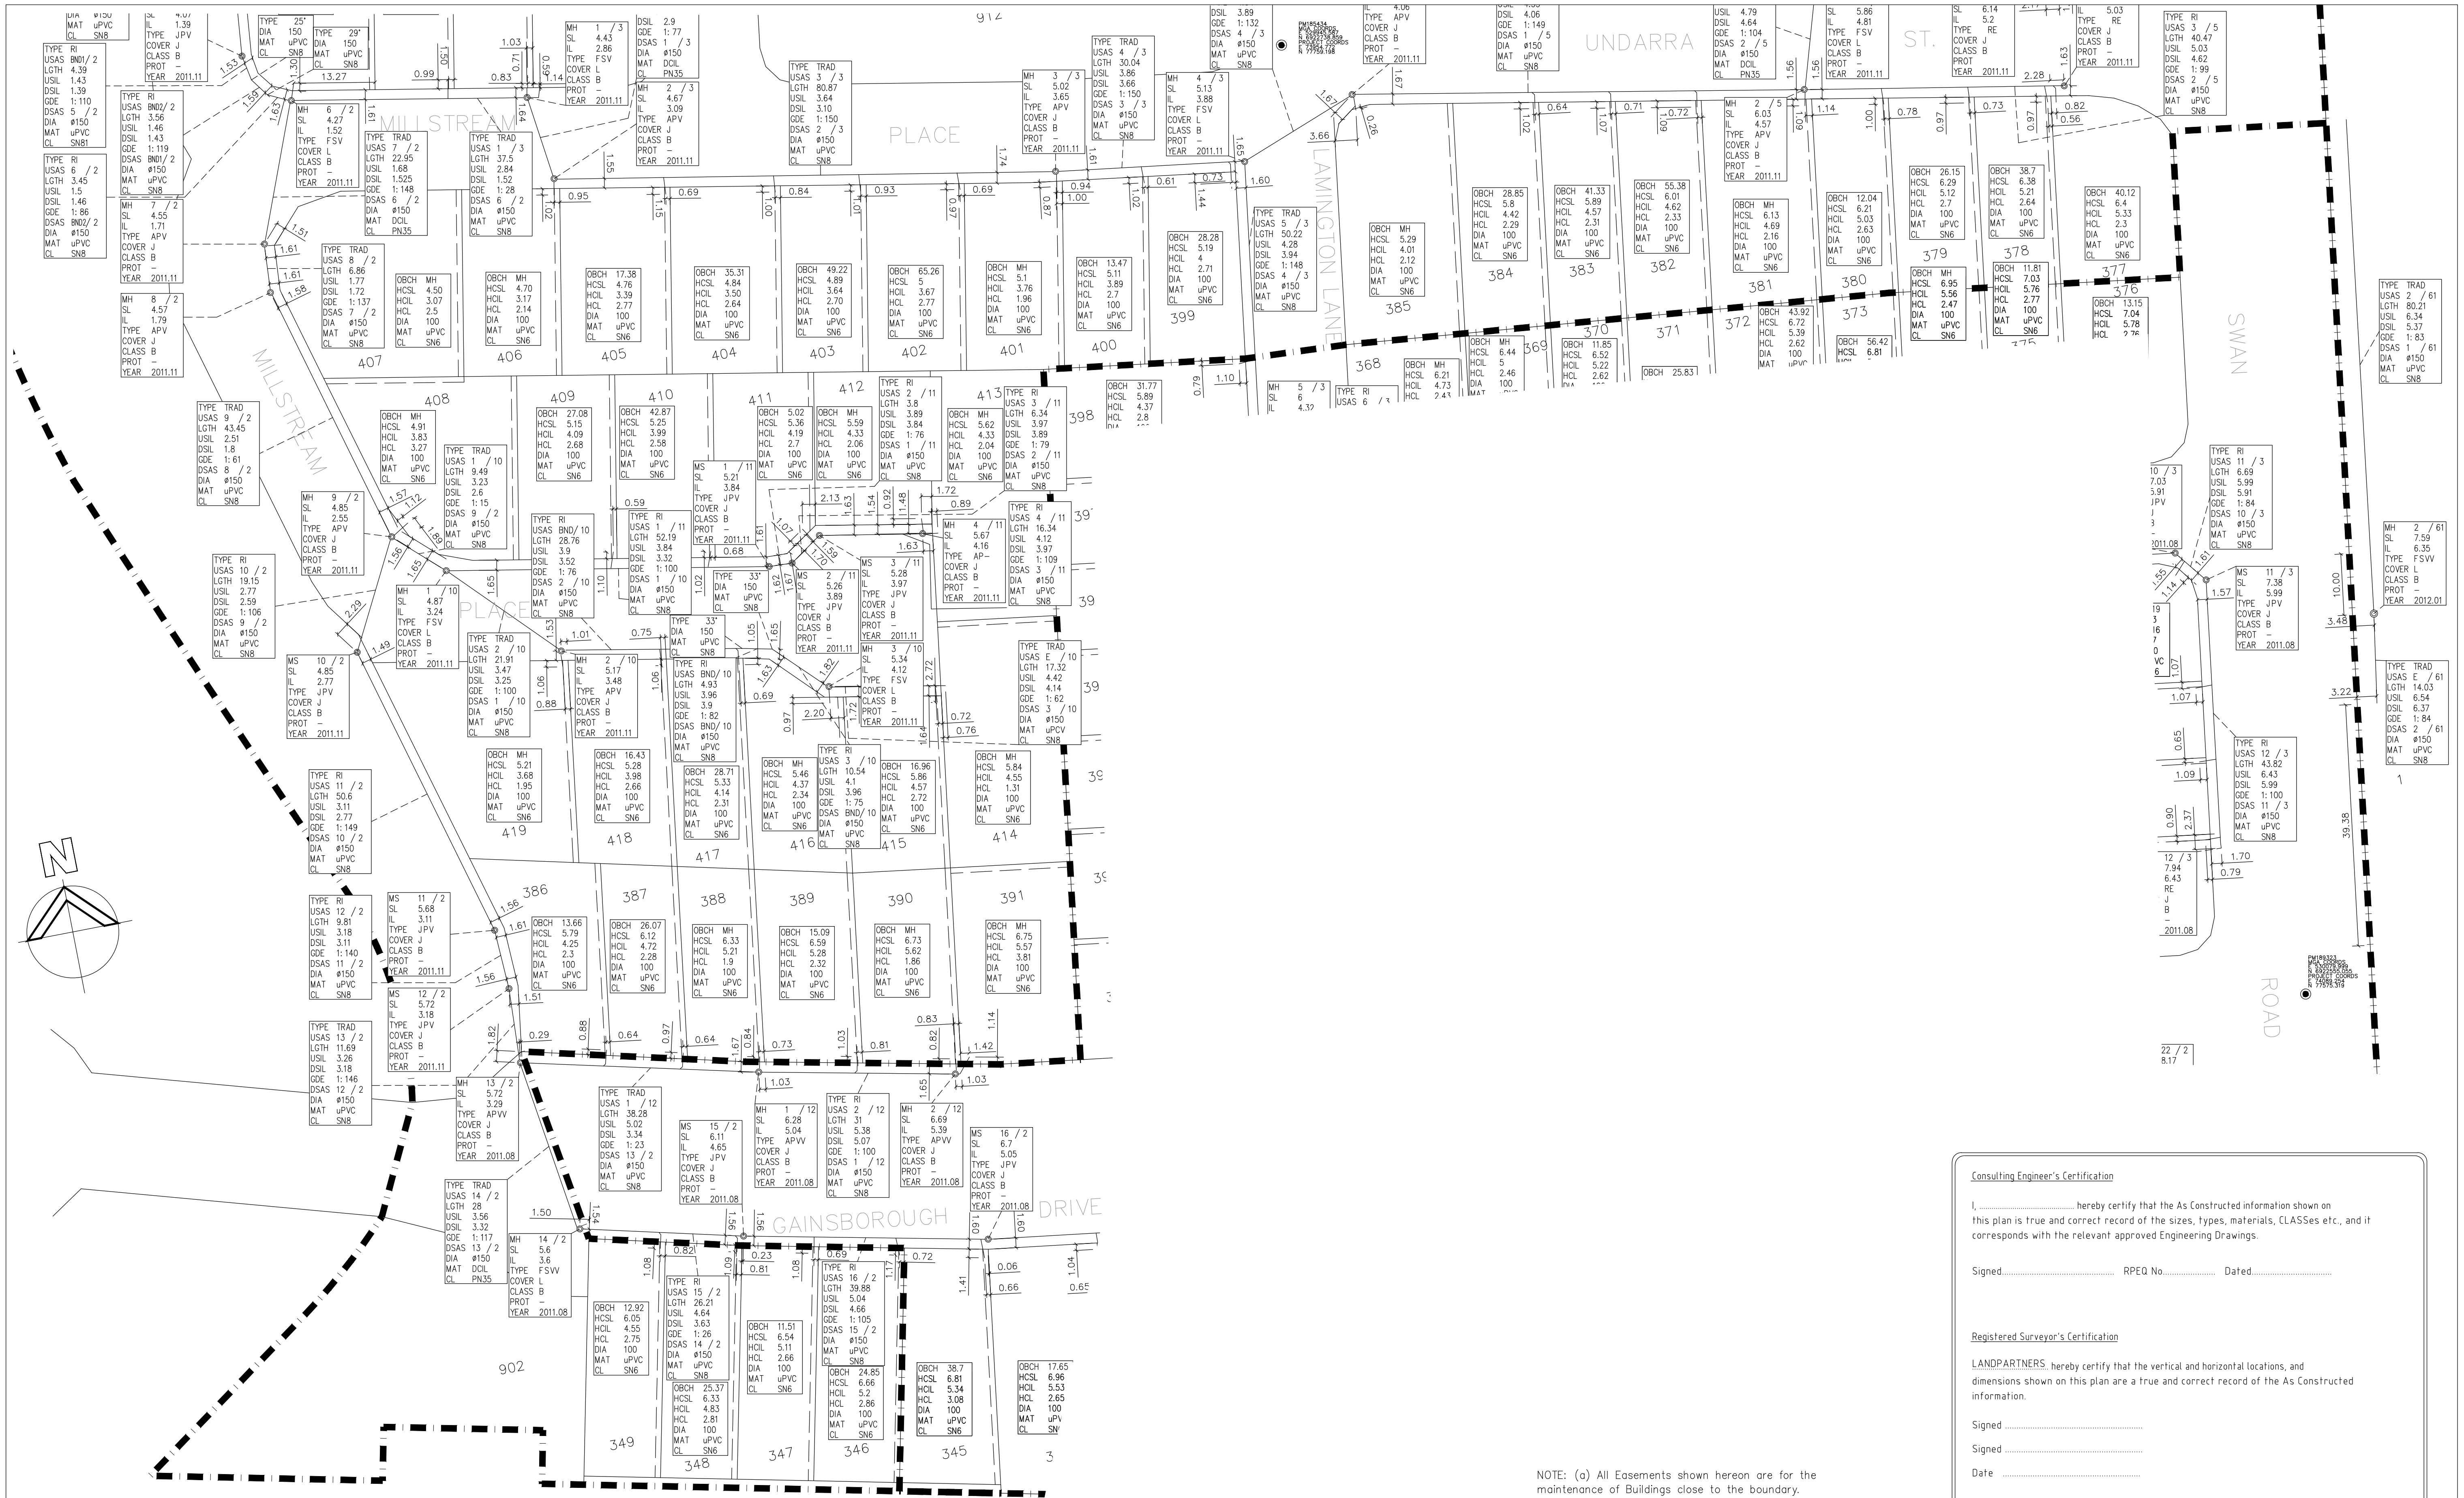

NOTE: (a) All Easements shown hereon are for the maintenance of Buildings close to the boundary.

Consulting Engineer's Certification

I, hereby certify that the As Constructed information shown on this plan is true and correct record of the sizes, types, materials, CLASSES etc., and it corresponds with the relevant approved Engineering Drawings.

Signed..... RPEQ No..... Dated.....

Registered Surveyor's Certification

LANDPARTNERS hereby certify that the vertical and horizontal locations, and dimensions shown on this plan are a true and correct record of the As Constructed information.

Signed.....

Signed.....

Date

IPUE	DATE	AUTHOR	COMMENTS	ISSUE	DATE	AUTHOR	COMMENTS
A	05/12/2011	ASW	PRELIMINARY IPUE	I	25/06/2012	PJH	DETAIL UPDATE
B	22/12/2011	ASW	DETAIL UPDATE	J	27/06/2012	CMA	COVER TYPES AMENDED
C	28/12/2011	PJH	ADDED MIPING DETAIL				
D	03/01/2012	PJH	DETAIL UPDATE				
E	10/01/2012	PJH	DETAIL UPDATE				
F	13/01/2012	PJH	DETAIL UPDATE				
G	18/01/2012	PJH	DETAIL UPDATE				
H	11/04/2012	PJH	DETAIL UPDATE				



Brisbane Office
13 Railway Terrace
Milton QLD 4064
PO Box 3916
South Brisbane BC QLD 4101
t (07) 3842 1000
e info@landpartners.com.au
w www.landpartners.com.au

CLIENT

MIRVAC PACIFIC

PROJECT

GAINSBOROUGH GREENS
PRECINCT 6.2 SEWER
AS CONSTRUCTED FINAL
LOTS 346-349, 377-391, 399-466,
901, 902 & 912 on SP242344

APOCIATE CONSULTANT

KN GROUP PTY LTD

LOCAL GOVERNMENT

GOLD COAST CITY COUNCIL

SCALE

0 10 25 55m

SCALE 1:500 (A1)

DATUM

AHDD

LEVEL ORIGIN

PSM 166836 RL 6.838

CONTOUR INTERVAL

N/A

COMPUTER FILE

459506U9

DRAWN

CMA

DATE

27/06/2012

CHECKED

ADR

DATE

27/06/2012

APPROVED

DATE

PLAN NUMBER

BRJD4595-006-047

IPUE

J

SHEET 2 of 2