

I,, hereby certify that the As Constructed information shown on this plan is true and correct record of the sizes, types, materials, classes etc., and it corresponds with the relevant approved Engineering Drawings.

LANDPARTNERS, hereby certify that the vertical and horizontal locations, and dimensions shown on this plan are a true and correct record of the As Constructed information.

Date


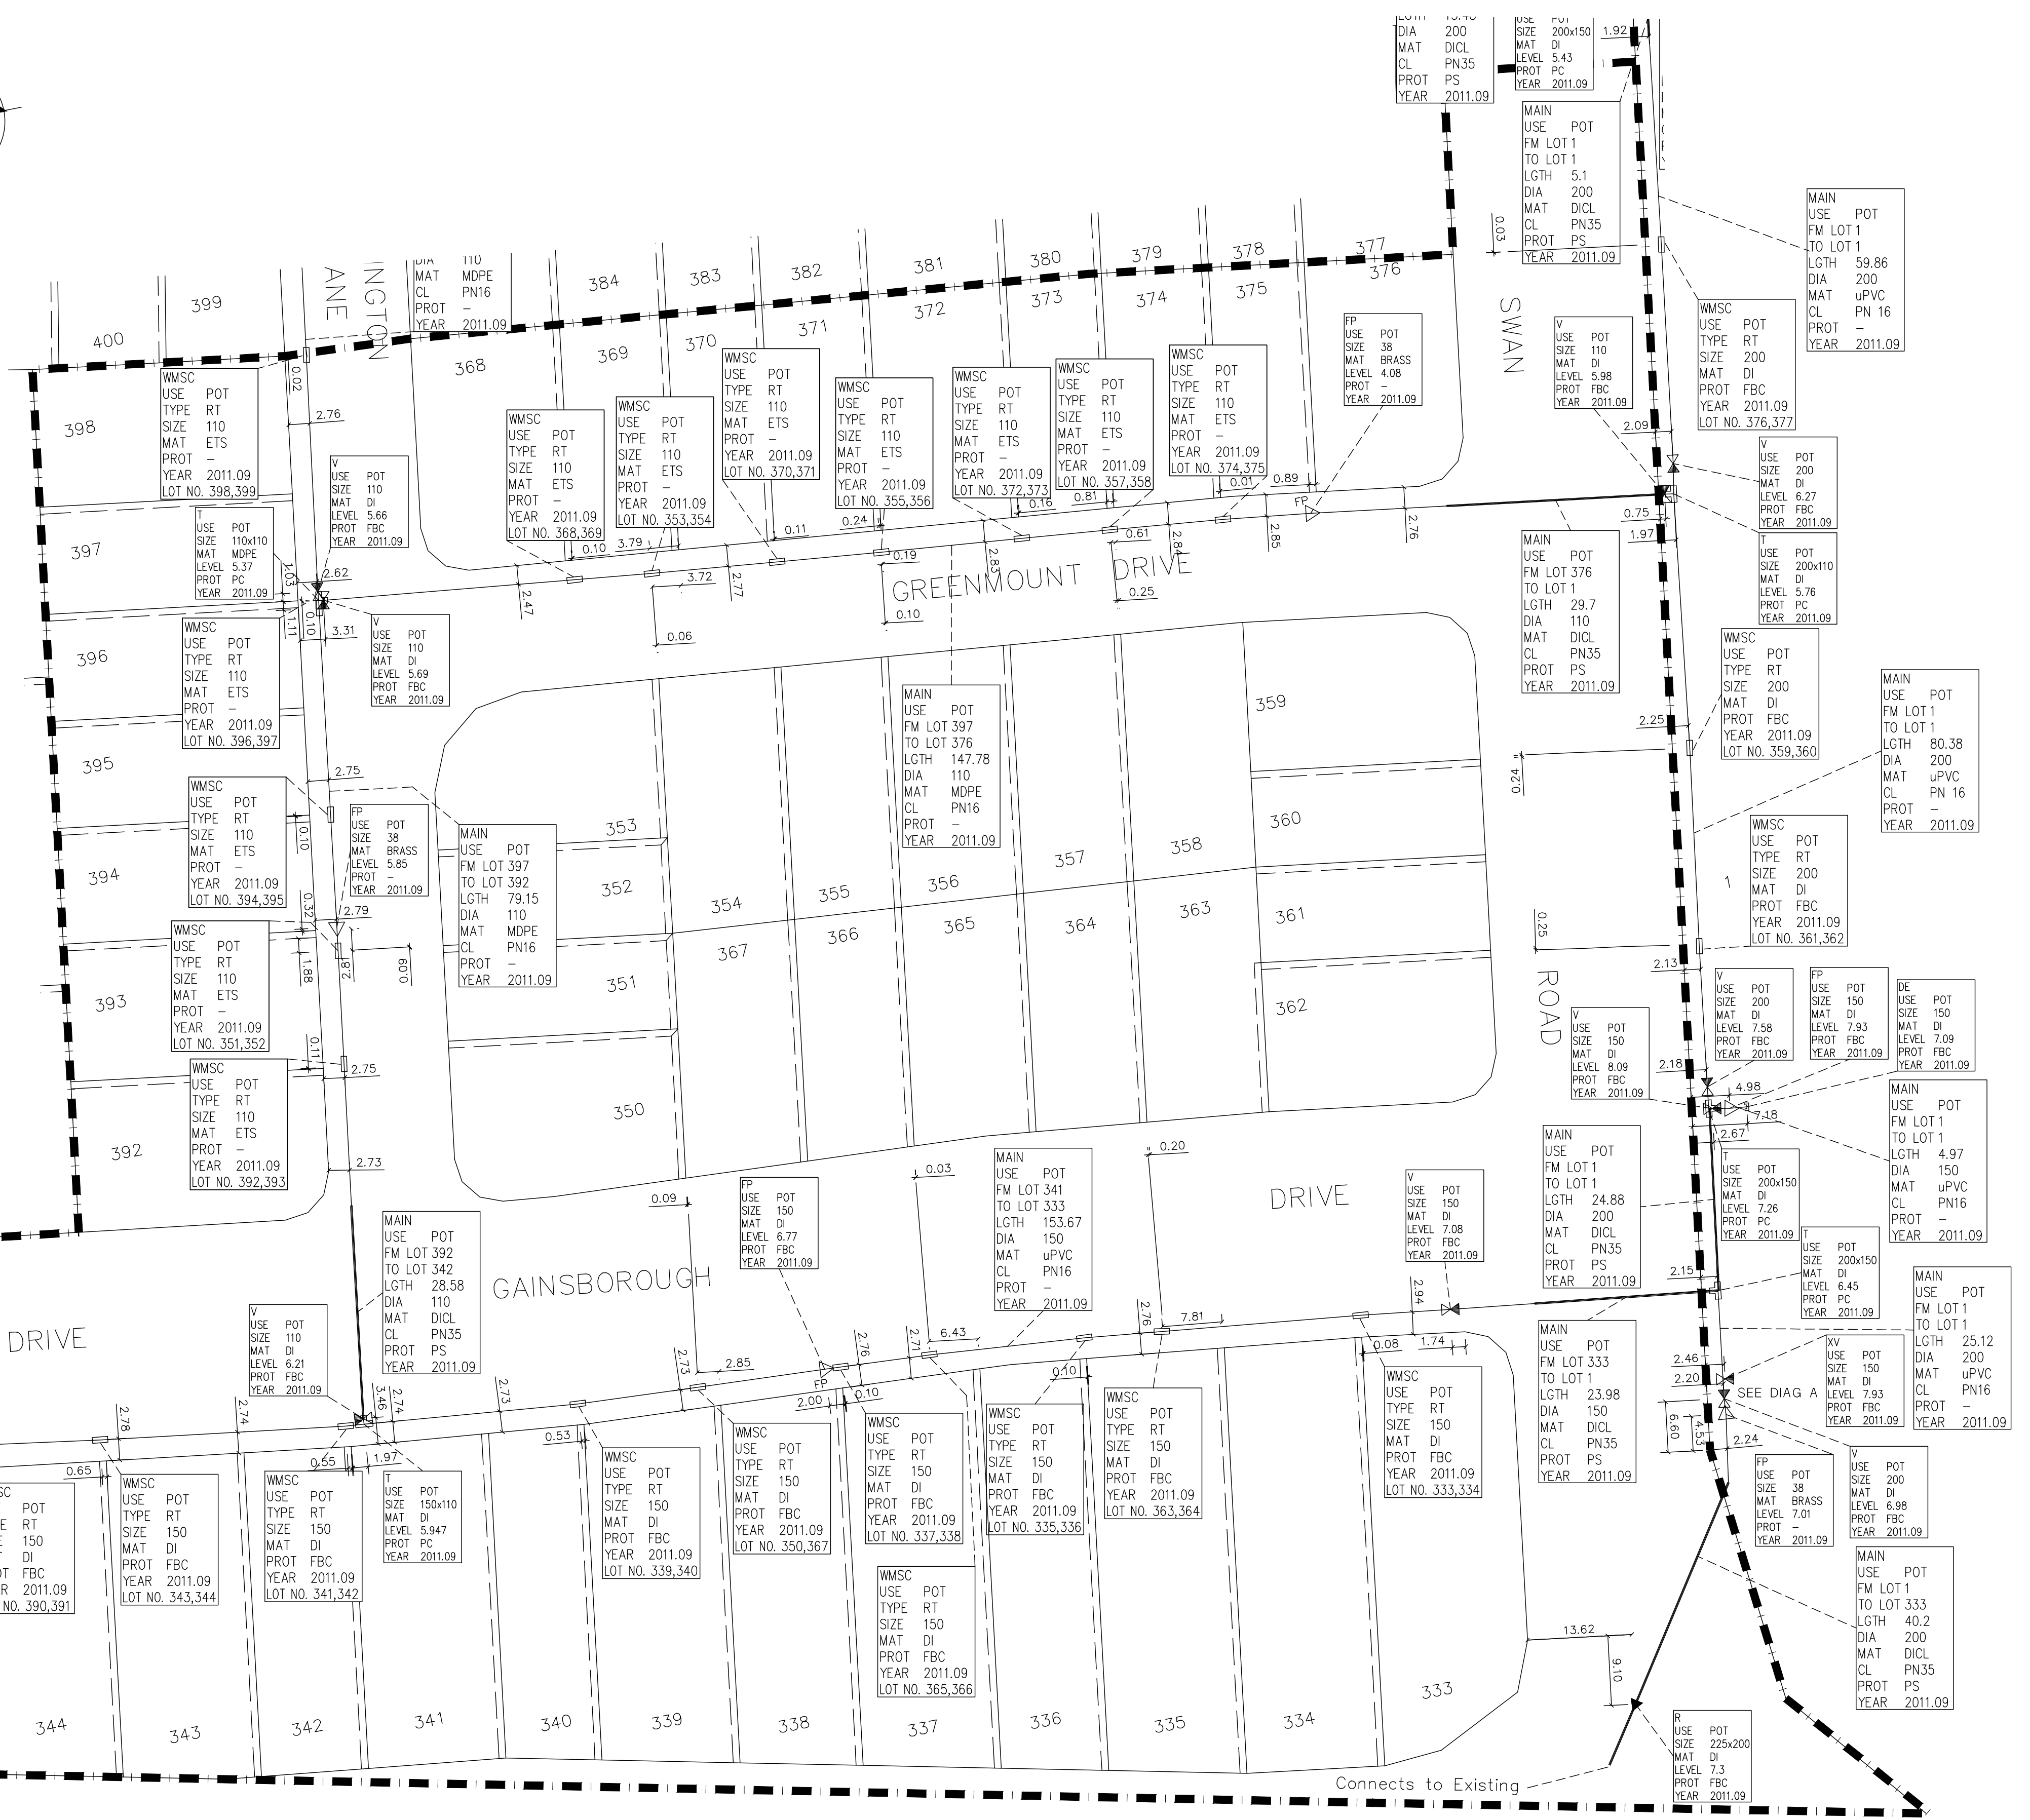


DIAGRAM A

ISSUE	DATE	AUTHOR	COMMENTS
A	02/02/2012	P.JH	PRELIMINARY ISSUE
B	14/04/2012	P.JH	MINOR AMENDMENTS
C	25/06/2012	P.JH	MINOR AMENDMENTS

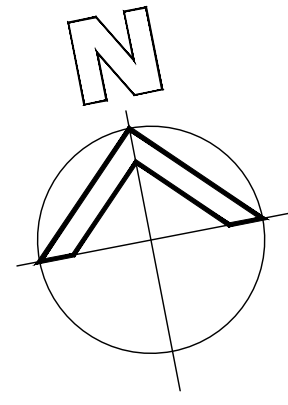

Brisbane Office
13 Railway Terrace
Milton QLD 4064
PO Box 3916
South Brisbane BC QLD 4101
t (07) 3842 1000
f (07) 3842 1001
e info@landpartners.com.au
w www.landpartners.com.au


ISO 9001:2008
FS 535063


PROJECT GAINSBOROUGH GREENS
PRECINCT 6.1 POTABLE WATER
AS CONSTRUCTED FINAL
LOTS 333-345, 350-376 & 392-398
on SP242343


SCALE

0 10 25 55m

SCALE 1:500 (A1)

DATUM		AHDD	
LEVEL ORIGIN		PSM 166836 RL 6 838	
CONTOUR INTERVAL		N/A	
COMPUTER FILE		459506U4	
DRAWN	P _{JH}	DATE	25/06/2012
CHECKED	P _{JH}	DATE	25/06/2012
APPROVED	JHD	DATE	25/06/2012
PLAN NUMBER			ISSUE
BRJD4595-006-049			C

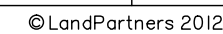

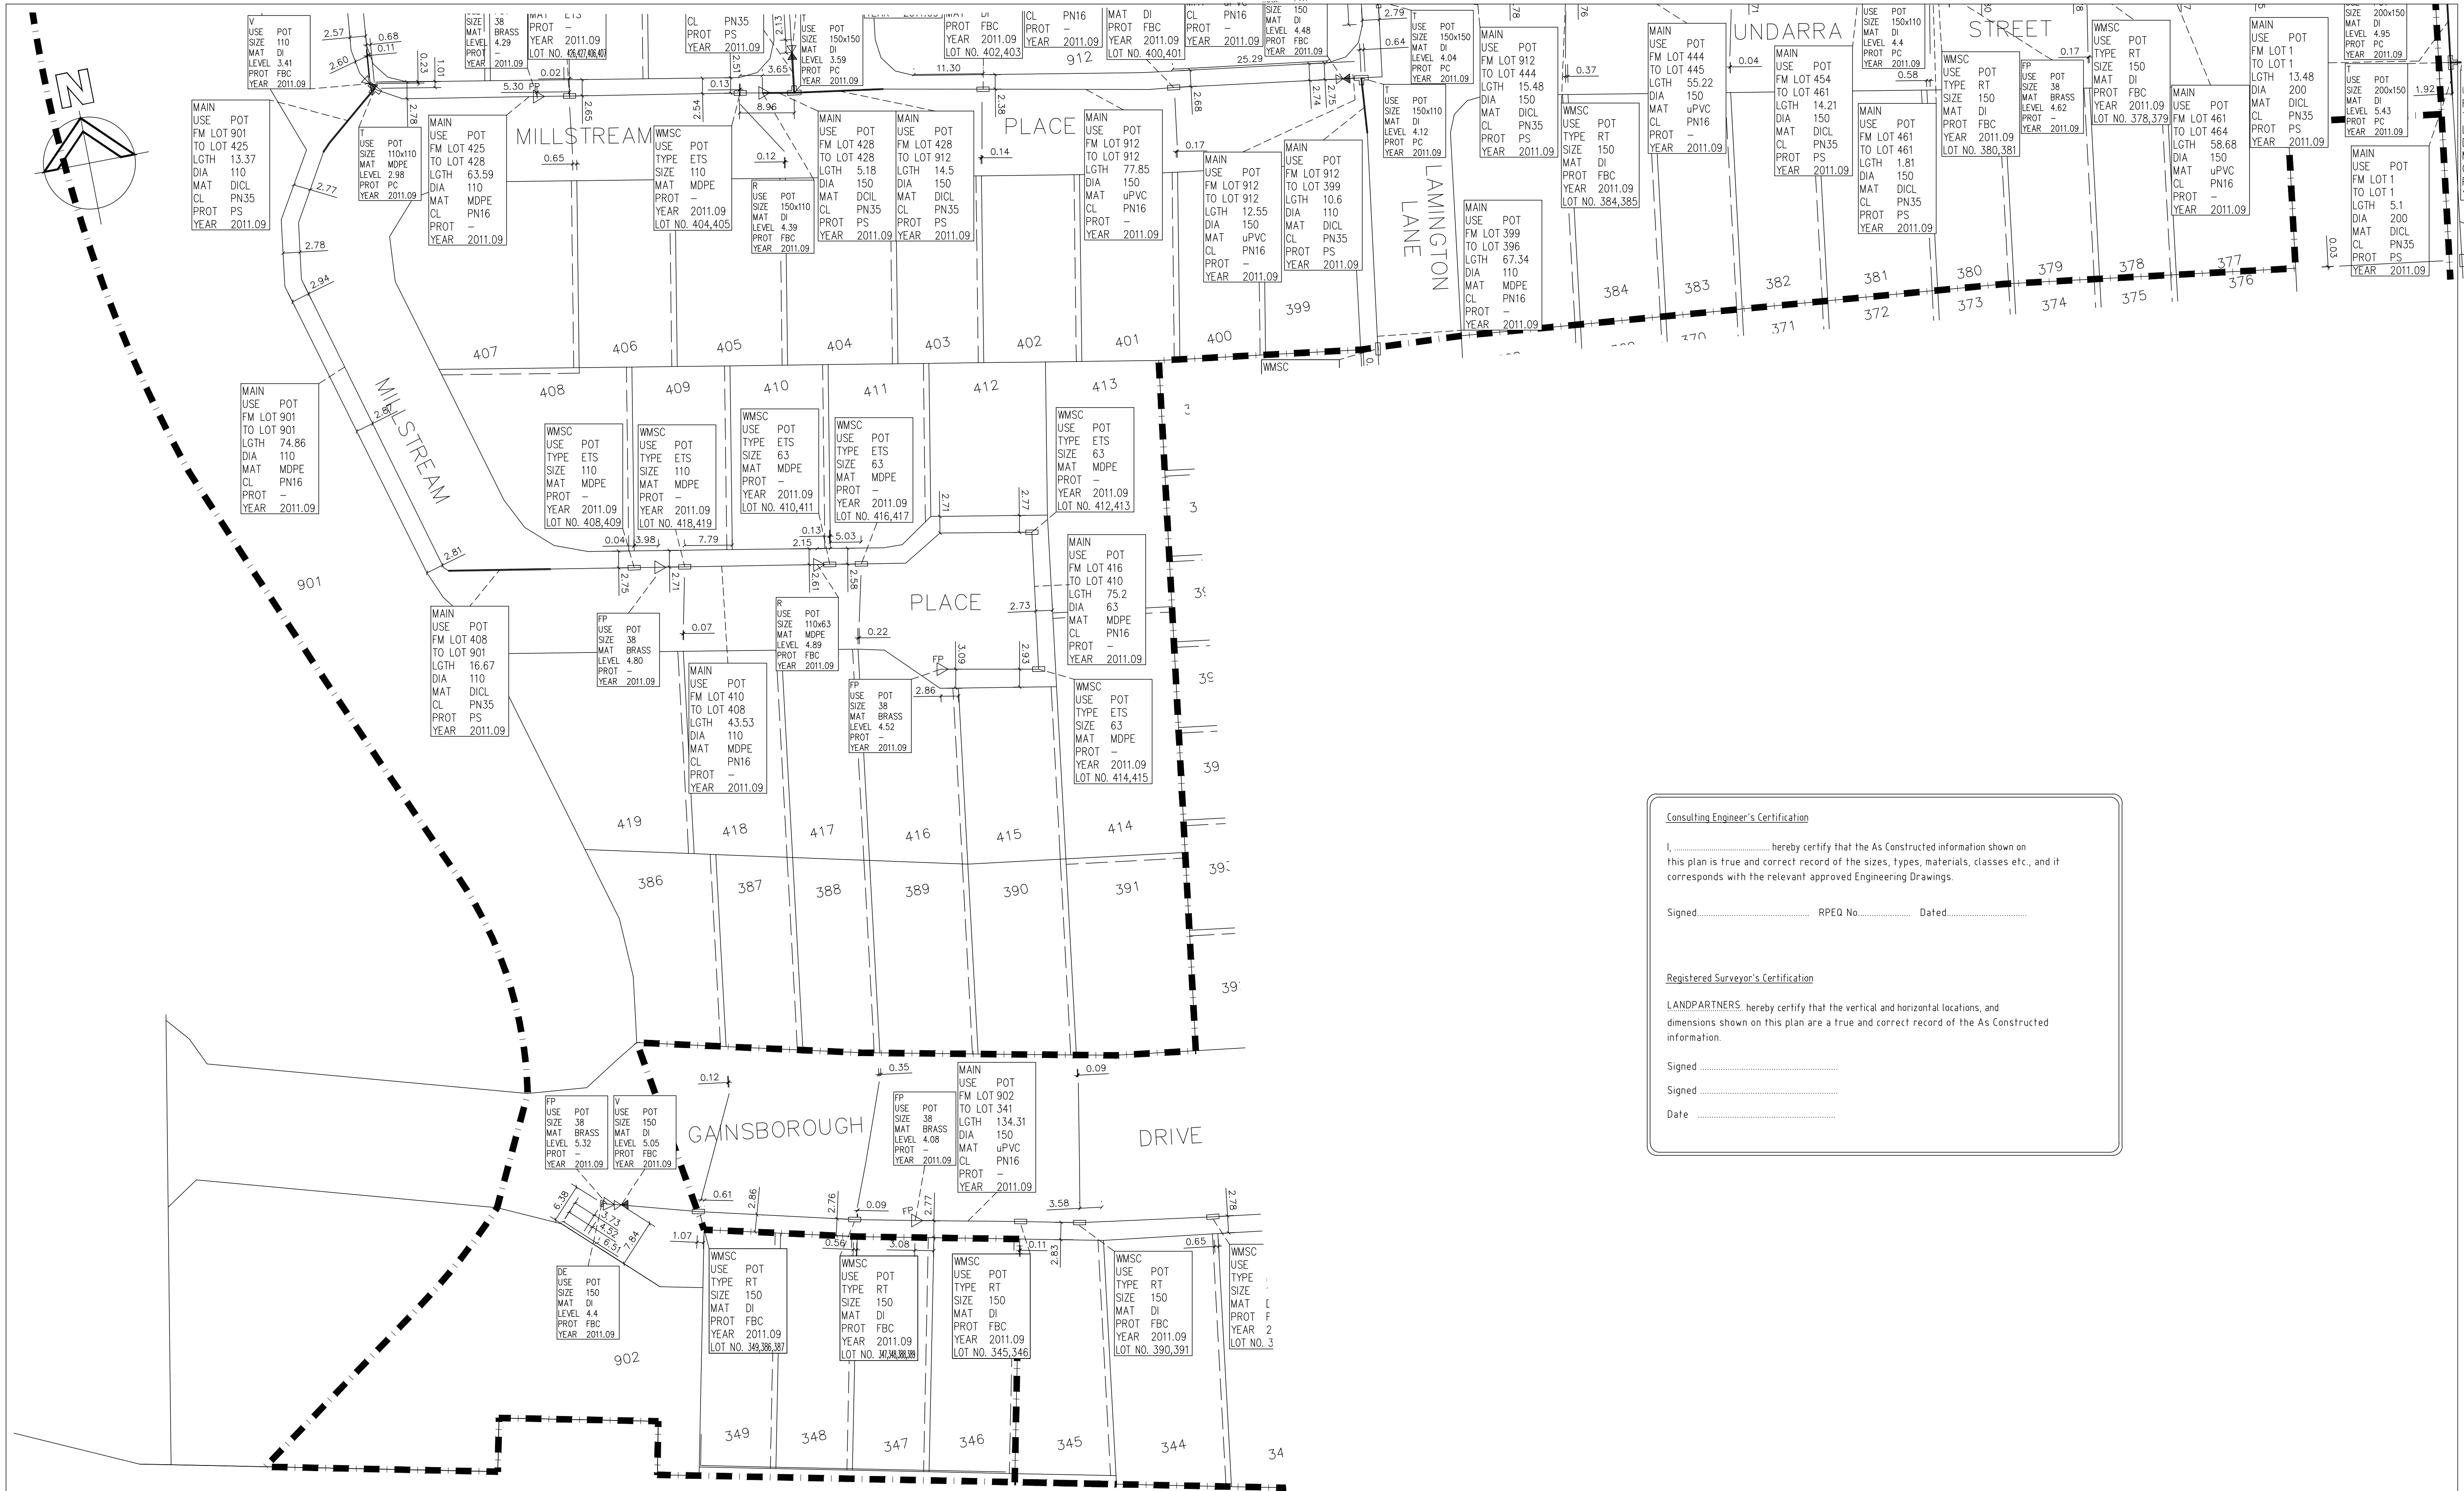

Consulting Engineer's Certification

I, hereby certify that the As Constructed information shown on this plan is true and correct record of the sizes, types, materials, classes etc., and it corresponds with the relevant approved Engineering Drawings.

Signed..... RPEQ No..... Dated.....

Registered Surveyor's Certification

LANDPARTNERS hereby certify that the vertical and horizontal locations, and dimensions shown on this plan are a true and correct record of the As Constructed information.

Signed

Signed

Date

ISSUE	DATE	AUTHOR	COMMENTS
A	02/02/2012	P.J.H.	PRELIMINARY ISSUE
B	17/04/2012	P.J.H.	MINOR AMENDMENTS
C	25/06/2012	P.J.H.	MINOR AMENDMENTS
D	27/06/2012	ADR	DETAILS UPDATED AT INTSN MILLSTREAM/LAMINGTON (JD)



LANDPARTNERS
built environment consultants

Brisbane Office
13 Railway Terrace
Milton QLD 4064
PO Box 3916
South Brisbane BC QLD 4101
t (07) 3842 1000
f (07) 3842 1001
e info@landpartners.com.au
w www.landpartners.com.au



ISO 9001:2008
FS 535963

CLIENT	MIRVAC PACIFIC
PROJECT	GAINSBOROUGH GREENS PRECINCT 6.2 POTABLE WATER AS CONSTRUCTED FINAL LOTS 346-349, 377-391, 399-466, 901, 902 & 912 on SP242344

ASSOCIATE CONSULTANT	KN GROUP PTY LTD
LOCAL GOVERNMENT	GOLD COAST CITY COUNCIL
SCALE	0 10 25 55m SCALE 1:500 (A1)

DATUM		AHDD	
LEVEL ORIGIN		PSM 166836 RL 6.838	
CONTOUR INTERVAL		N/A	
COMPUTER FILE 459506U4			
DRAWN	ADR	DATE	27/06/2012
CHECKED	ADR	DATE	27/06/2012
APPROVED	JHD	DATE	27/06/2012
PLAN NUMBER BRJD4595-006-050			REVISION D
SHEET 2 OF 2			